EXACTA
Land Surveyors, LLC

www.exactaland.com | office: 866.735.1916 | fax: 866.744.2882



PROPERTY ADDRESS:
10616 NE 76 TERRACE, GAINESVILLE, FLORIDA 32609

SURVEY NUMBER: 2512.2653

CERTIFIED TO:

BUYER:

LENDER:

TITLE COMPANY:

COMMITMENT DATE: NOT REVIEWED | **CLIENT FILE NO:**

LEGAL DESCRIPTION:

THAT PART OF THE SOUTHWEST 1/4 OF SECTION 31, TOWNSHIP 8 SOUTH, RANGE 21 EAST, ALACHUA COUNTY, FL, BEING MORE PARTICULARLY DESCRIBED AS FOLLOWS: COMMENCE AT THE SOUTHWEST CORNER OF SAID SECTION 31 FOR A POINT OF REFERENCE; THENCE RUN SOUTH 89°23'34" EAST ALONG THE SOUTH LINE OF SAID SECTION 31, A DISTANCE OF 1320.0 FEET; THENCE RUN NORTH 00°38'26" EAST PERPENDICULAR TO THE SAID SOUTH LINE OF SECTION 31, A DISTANCE OF 1340.00 FEET; THENCE RUN NORTH 09° 52'37" EAST, A DISTANCE OF 759.81 FEET TO THE POINT OF BEGINNING; FROM THE SAID POINT OF BEGINNING, CONTINUE NORTH 09°52'37" EAST, A DISTANCE OF 618.91 FEET; THENCE RUN NORTH 00°36'26" EAST PERPENDICULAR TO THE SAID SOUTH LINE OF SECTION 31, A DISTANCE OF 40.00 FEET; THENCE RUN SOUTH 89° 23'34" EAST PARALLEL TO THE SAID SOUTH LINE OF SECTION 31, A DISTANCE OF 500.02 FEET; THENCE RUN SOUTH 30°36'26" WEST, A DISTANCE OF 278.19 FEET TO THE BEGINNING OF A CURVE CONCAVE TO THE EAST, HAVING A TOTAL CENTRAL ANGLE OF 60°00'00" AND A RADIUS OF 1140.00 FEET; THENCE RUN SOUTHWESTERLY ALONG THE ARC OF THE SAID CURVE, THROUGH AN ANGLE OF 21°55'38" AN ARC DISTANCE OF 436.28 FEET; THENCE RUN NORTH 89°23'34" WEST PARALLEL TO THE SAID SOUTH LINE OF SECTION 31, A DISTANCE OF 319.19 FEET TO THE SAID POINT OF BEGINNING

JOB SPECIFIC SURVEYOR NOTES
THE BEARING REFERENCE OF NORTH 89 DEGREES 23 MINUTES 34 SECONDS WEST IS BASED ON THE NORTHERLY RIGHT-OF-WAY LINE OF NE 108TH AVENUE, LOCATED WITHIN THE SW 1/4 OF SECT.31, TWP 8 S RGE 21 E, ACCORDING TO THE DEED THEREOF, AS RECORDED IN OFFICIAL RECORD BOOK 5197 , PAGE 1948 OF THE PUBLIC RECORDS OF ALACHUA COUNTY, FLORIDA.

DATE SIGNED: 02/16/26 | **FIELD WORK DATE:** 2/13/2026

REVISION DATE(S):
(REV.1 2/16/2026)

POINTS OF INTEREST
NONE VISIBLE

JOHN E. KROBATH
License Number LS7368
STATE OF FLORIDA
PROFESSIONAL SURVEYOR & MAPPER

JOHN E. KROBATH
State of Florida Professional Surveyor and Mapper
License Number 7368
Exacta Land Surveyors, LLC | LB# 8291

SURVEYORS CERTIFICATE
I hereby certify that this Survey of the lands described hereon was made under my direct supervision, and to the best of my knowledge and belief is a true and accurate representation of said lands and meets the Standards of Practice set forth in Chapter 5J-17.050 through 5J -17.053, Florida Administrative Code, pursuant to section 472.027, Florida Statutes. This survey is not valid without the signature and original raised seal of a Florida licensed surveyor and mapper, except when the electronic signature and seal of a Florida licensed surveyor and mapper is affixed hereto.

EXACTA
Exacta Land Surveyors, LLC
LB# 8291
o: 866.735.1916 | f: 866.744.2882
131 West Broadway Street, Suite 1001, Oviedo, FL 32765

Florida Land Title Association
FLTA
AFFILIATE MEMBERS

2512.2653
BOUNDARY SURVEY
ALACHUA COUNTY

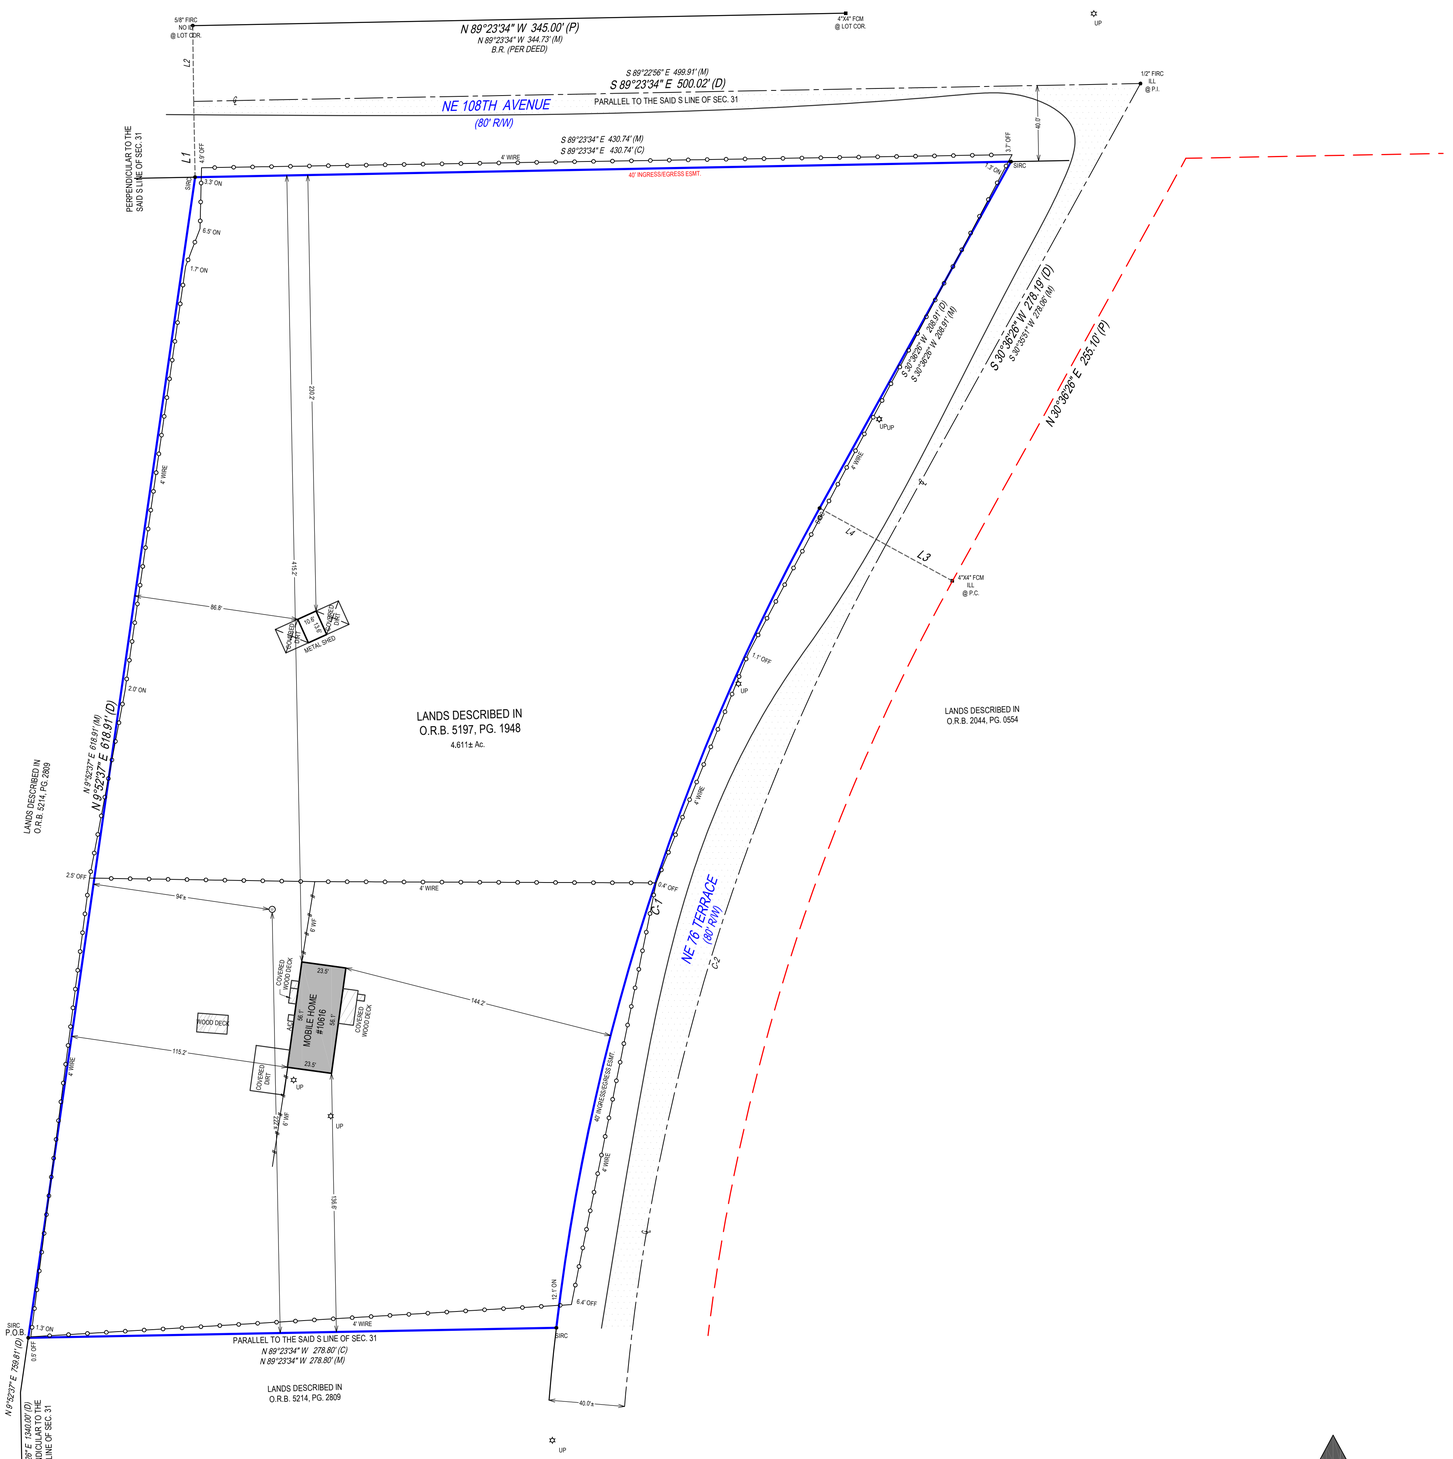

C-1	
R=	1180.00'(P&M)
L=	457.26'(P) 457.26'(M)
Δ=	22°12'09"(P) 22°12'09"(M)
N 19°30'21" E	454.40'
N 19°30'21" E	454.40'(M)

C-2	
R=	1140.00'(P&M)
L=	478.46'(P) 478.46'(M)
Δ=	24°02'50"(P) 24°02'50"(M)
S 18°33'52" W	474.96'
S 18°33'52" W	474.96'(M)

SURVEYOR'S NOTES:
FENCE OWNERSHIP NOT DETERMINED.

LINE TABLE		
LINE	BEARING	DISTANCE
L1	N 0°36'26" E	40.00' (D)
	N 0°36'26" E	40.00' (M)
L2	N 0°36'26" E	40.00' (D)
	S 0°59'15" W	40.00' (M)
L3	S 59°23'34" E	40.00' (P)
	S 59°44'55" E	39.96' (M)
L4	N 59°23'34" W	40.00' (P)
	N 59°23'34" W	40.00' (M)

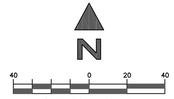

GENERAL SURVEYORS NOTES:

1. The Legal Description used to perform this survey was supplied by others. This survey does not determine nor imply ownership of the lands or any fences shown hereon. Unless the Title Commitment Number and Date is referenced on this survey, an examination of the abstract of title was NOT performed by the signing surveyor to determine which instruments, if any, are affecting this property.
2. Unless otherwise noted, any utility information shown hereon is based on above-ground visible evidence, record drawings, or information provided by others. The surveyor does not certify the existence, absence, depth, size, material, condition, or completeness of underground utilities or service lines that may be shown. No subsurface investigation was carried out as part of this survey.
3. If an onsite sanitary sewer disposal system is shown on this survey, its location is based on information provided by others and/or visible surface indicators observed at the time of field survey. The surveyor did not attempt to uncover, excavate, probe, or otherwise determine the location, size, condition, or extent of the system. Actual field conditions may vary. Verification or exposure of a septic system requires a Florida-licensed Septic Contractor per FDOH (Chapter 64E-6 FAC).
4. This survey is for the exclusive use and reliance of the certified parties. Any other use or reliance without the written consent of the signing Professional Surveyor and Mapper is strictly prohibited.
5. Flood zone information, if shown, is based on published FEMA Flood Insurance Rate Maps (FIRMs) and is provided for reference only. It may not reflect recent revisions, Letters of Map Amendment (LOMAs), Letters of Map Revision (LOMRs), or site-specific evaluations.
6. Survey monuments labeled "SIRC" indicate a Set Iron Rebar, a minimum ½ inch in diameter and 18 inches in length, with a yellow plastic cap stamped "EXACTA LB#8291" set at that location.
7. This survey has been electronically signed and sealed in accordance with F.A.C. 5J-17.062(3) and F.S. 472.025. The electronic signature is unique to the signing Professional Surveyor and Mapper, verifiable, and invalidates if the document is altered. If this document does not display a valid electronic signature, it is not an official copy. The corresponding electronic signature authentication record is prominently displayed on the invoice sent under separate cover for said verification.
8. The symbols reflected in the legend and on this survey may have been enlarged or reduced for clarity. The symbols have been plotted at the approximate center of the field location and may not represent the actual shape or size of the feature.
9. Points of Interest (POIs) are select above-ground features identified because of their proximity to boundary lines, building setback lines, or known recorded easements. POIs are not intended to identify all matters of interest located on the property. Additional improvements may exist that are not visible, accessible or known to the surveyor at the time of the survey.
10. The information shown on this survey was compiled and prepared exclusively by Exacta Land Surveyors, LLC. Exacta is solely responsible for the professional content of this survey. Any third-party names, logos, or references appearing on this survey are provided only for identification purposes and do not imply endorsement or responsibility.
11. Pursuant to F.S. 558.0035, individual employees and agents of Exacta Land Surveyors, LLC shall not be held personally liable for negligence. Responsibility for this survey rests solely with the surveying firm.
12. Building dimensions shown on this survey are approximate and are not intended to be used for design, permitting, or construction, unless specifically contracted and stated otherwise on this survey.
13. Unless otherwise noted, the horizontal datum used for this survey is NAD83(2011), Epoch 2010.00. Coordinates and bearings are referenced to the Florida State Plane Coordinate System, in the applicable Zone. Positions were established using survey-grade GNSS observations processed through the Florida Permanent Reference Network (FPRN) CORS/VRS network and tied to the National Spatial Reference System (NSRS) and expressed in U.S. Survey Feet.
14. Unless otherwise noted, the vertical datum used for this survey is based on the North American Vertical Datum of 1988 (NAVD88), derived from observations processed through the Florida Permanent Reference Network (FPRN) CORS network, adjusted using GEOID18, and expressed in U.S. Survey Feet.

SURVEYORS LEGEND:

LINETYPES
- Boundary Line
- Center Line
- Chain Link or Wire Fence
- Easement
- Edge of Water
- Iron Fence
- Overhead Lines
- Structure
- Survey Tie Line
- Vinyl Fence
- Wall or Party Wall
- Wood Fence

SURFACE TYPES
- Asphalt
- Brick or Tile
- Concrete
- Covered Area
- Water
- Wood

SYMBOLS
- Benchmark
- Center Line
- Central Angle or Delta
- Common Ownership
- Control Point
- Catch Basin
- Elevation
- Fire Hydrant
- Find or Set Monument
- Guywire or Anchor
- Manhole
- Tree
- Utility or Light Pole
- Well

ABBREVIATIONS
(C) - Calculated
(D) - Deed
(F) - Field
(M) - Measured
(P) - Plat
(R) - Record
(S) - Survey
A/C - Air Conditioning
AE - Access Easement
ANE - Anchor Easement
ASBL - Accessory Setback Line
B/W - Bay/Box Window
BC - Block Corner
BFP - Backflow Preventer
BLDG - Building
BLK - Block
BM - Benchmark
BR - Bearing Reference
BRL - Building Restriction Line
BSMT - Basement
C - Curve
C/L - Center Line
C/P - Covered Porch
C/S - Concrete Slab
CATV - Cable TV Riser
CB - Concrete Block
CH - Chord Bearing
CHIM - Chimney
CLF - Chain Link Fence
CME - Canal Maintenance Easement
CO - Clean Out
CONC - Concrete
COR - Corner
CS/W - Concrete Sidewalk
CUE - Control Utility Easement
CVG - Concrete Valley Gutter
D/W - Driveway
DE - Drainage Easement
DF - Drain Field
DH - Drill Hole
DUE - Drainage & Utility Easement
ELEV - Elevation
EM - Electric Meter
ENCL - Enclosure
ENT - Entrance
EOP - Edge of Pavement
EOW - Edge of Water
ESMT - Easement
EUB - Electric Utility Box
F/DH - Found Drill Hole
FCM - Found Concrete Monument
FF - Finished Floor
FIP - Found Iron Pipe
FIPC - Found Iron Pipe & Cap
FIR - Found Iron Rod
FIRC - Found Iron Rod & Cap
FN - Found Nail
FN&D - Found Nail & Disc
FRRSPK - Found Rail Road Spike
GAR - Garage
GM - Gas Meter
ID - Identification
IE/EE - Ingress/Egress Easement
ILL - Illegible
INST - Instrument
INT - Intersection
IRRE - Irrigation Easement
L - Length
LAE - Limited Access Easement
LB# - License No. (Business)
LBE - Limited Buffer Easement
LE - Landscape Easement
LME - Lake/Landscape Maintenance Easement
LS# - License No. (Surveyor)
MB - Map Book
ME - Maintenance Easement
MES - Mitered End Section
MF - Metal Fence
MH - Manhole
MHWL - Mean High Water Line
NR - Non-Radial
NTS - Not to Scale
NAVD88 - North American Vertical Datum 1988
NGVD29 - National Geodetic Vertical Datum 1929
OG - On Ground
ORB - Official Records Book
ORV - Official Record Volume
O/A - Overall
O/S - Offset
OFF - Outside Subject Property
OH - Overhang
OHL - Overhead Utility Lines
OHWL - Ordinary High Water Line
ON - Inside Subject Property
P/E - Pool Equipment
PB - Plat Book
PC - Point of Curvature
PCC - Point of Compound Curvature
PCP - Permanent Control Point
PI - Point of Intersection
PLS - Professional Land Surveyor
PLT - Planter
POB - Point of Beginning
POC - Point of Commencement
PRC - Point of Reverse Curvature
PRM - Permanent Reference Monument
PSM - Professional Surveyor & Mapper
PT - Point of Tangency
PUE - Public Utility Easement
R - Radius or Radial
R/W - Right of Way
RES - Residential
RGE - Range
ROE - Roof Overhang Easement
RP - Radius Point
S/W - Sidewalk
SBL - Setback Line
SCL - Survey Closure Line
SCR - Screen
SEC - Section
SEP - Septic Tank
SEW - Sewer
SIRC - Set Iron Rod & Cap
SMWE - Storm Water Management Easement
SN&D - Set Nail and Disc
SQFT - Square Feet
STL - Survey Tie Line
STY - Story
SV - Sewer Valve
SWE - Sidewalk Easement
TBM - Temporary Bench Mark
TEL - Telephone Facilities
TOB - Top of Bank
TUE - Technological Utility Easement
TWP - Township
TX - Transformer
TYP - Typical
UE - Utility Easement
UG - Underground
UP - Utility Pole
UR - Utility Riser
VF - Vinyl Fence
W/C - Witness Corner
W/F - Water Filter
WF - Wood Fence
WM - Water Meter/Valve Box
WV - Water valve

FLOOD ZONE INFORMATION:
BY PERFORMING A SEARCH WITH THE LOCAL GOVERNING MUNICIPALITY OR WWW.FEMA.GOV, THE PROPERTY APPEARS TO BE LOCATED IN ZONE A. THIS PROPERTY WAS FOUND IN ALACHUA COUNTY UNINCORPORATED AREAS, COMMUNITY NUMBER 120001, PANEL NUMBER 0188 DATED 6/16/2006.